


9184-92

MAP
SHOWING AREA AND THE LOCATION AND DESCRIPTION OF
BUILDINGS, FEATURES AND IMPROVEMENTS THEREON
AT
HERMIT REST
HEAD OF HERMIT TRAIL
IN THE
GRAND CANYON NATIONAL PARK
TO BE OCCUPIED AND USED BY FRED HARVEY UNDER 20
YEAR CONTRACT WITH THE SECRETARY OF THE INTERIOR, DAY
ED FEBRUARY 26, 1920.


SCALE: 200 FT. TO 1 IN.
EXHIBIT D

Formerly used under Special Use Permit
U.S. Dept. of Agr. #5 5-28-1909 Exhibit C.

N.E. 1/4 SEC. 21.
T.31 N. R.2 E. G. & S. R. B. & M.

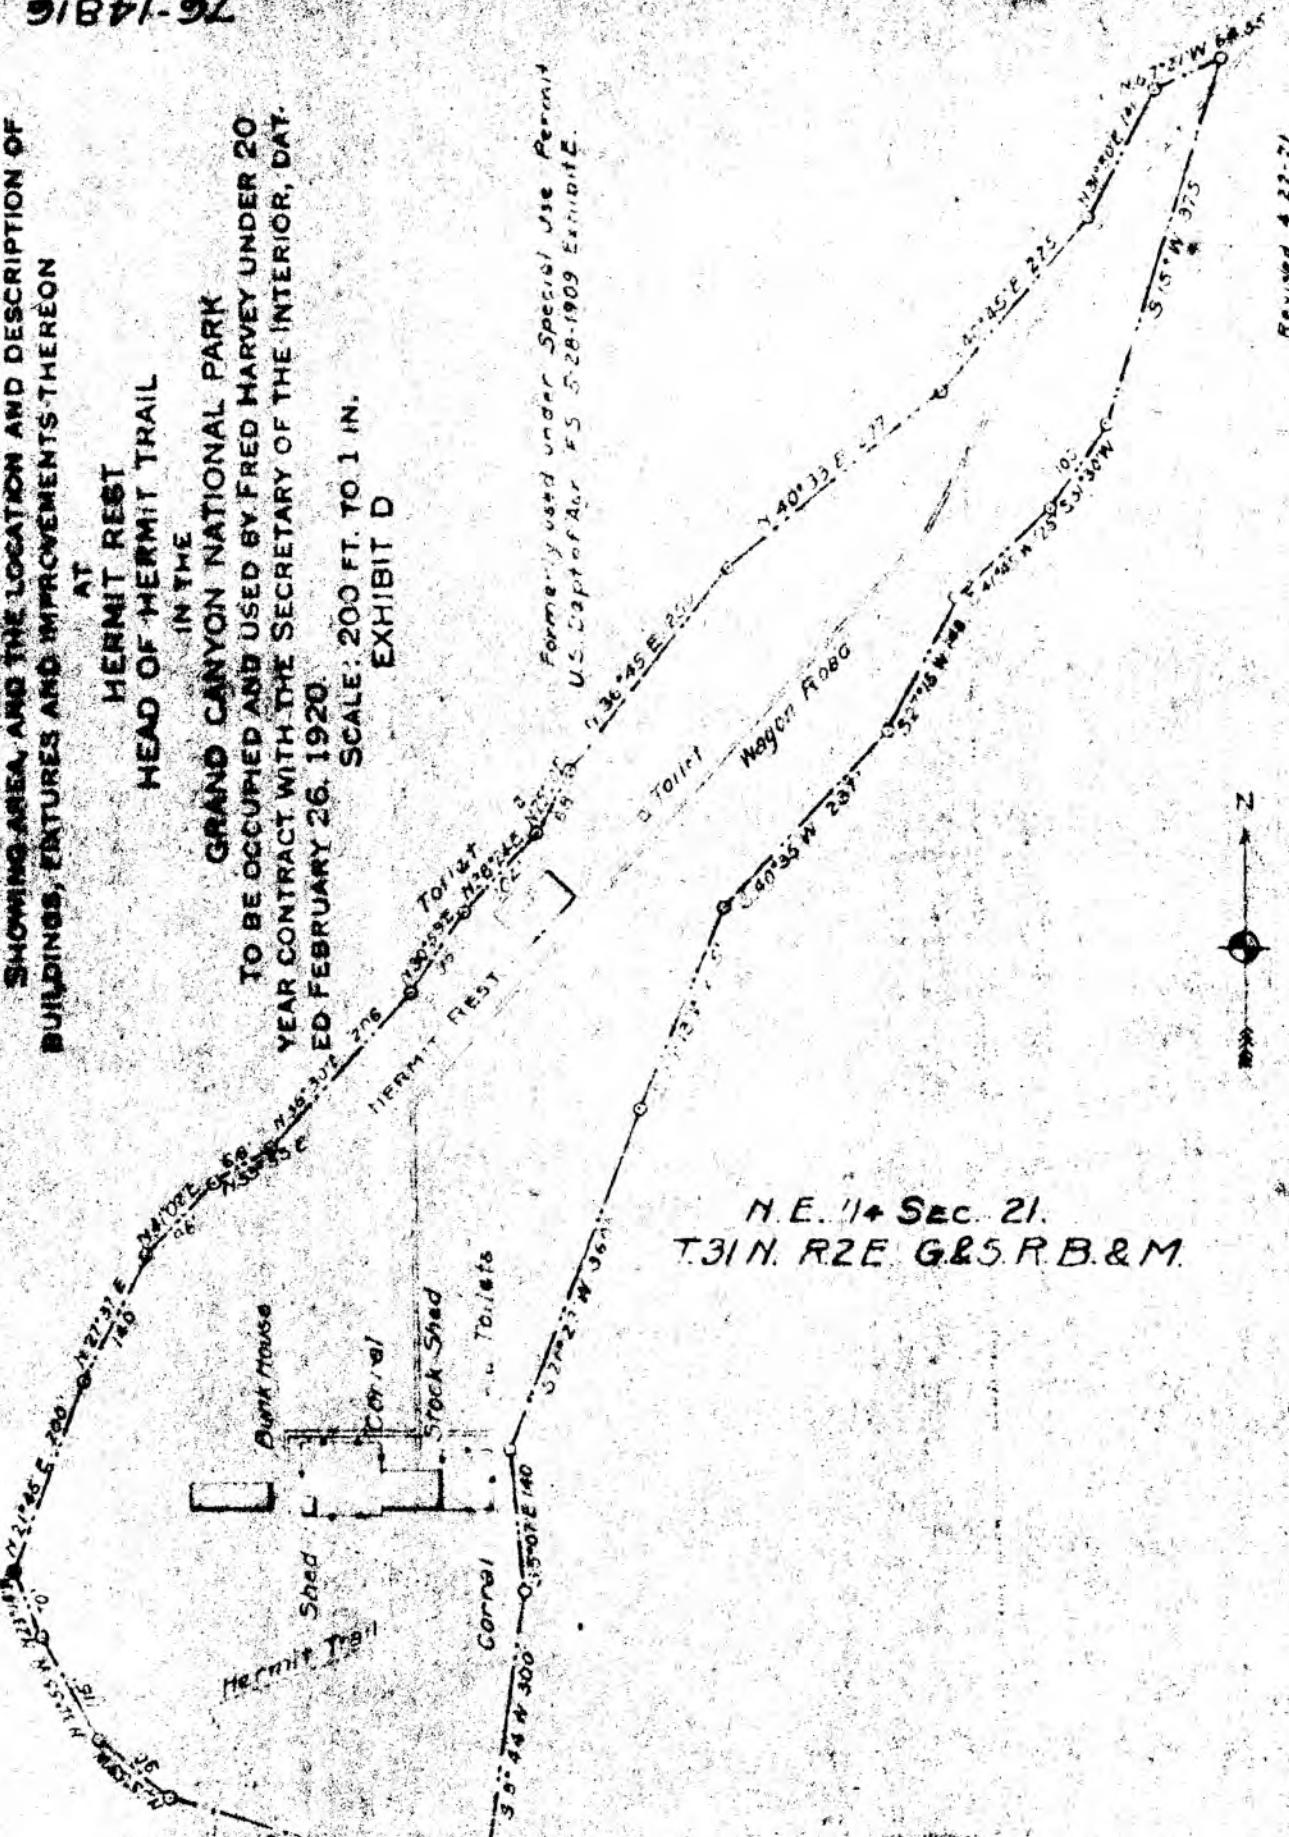


Revised 4 22-21.
C. & G. Coast Lines Draw No. 76-14816

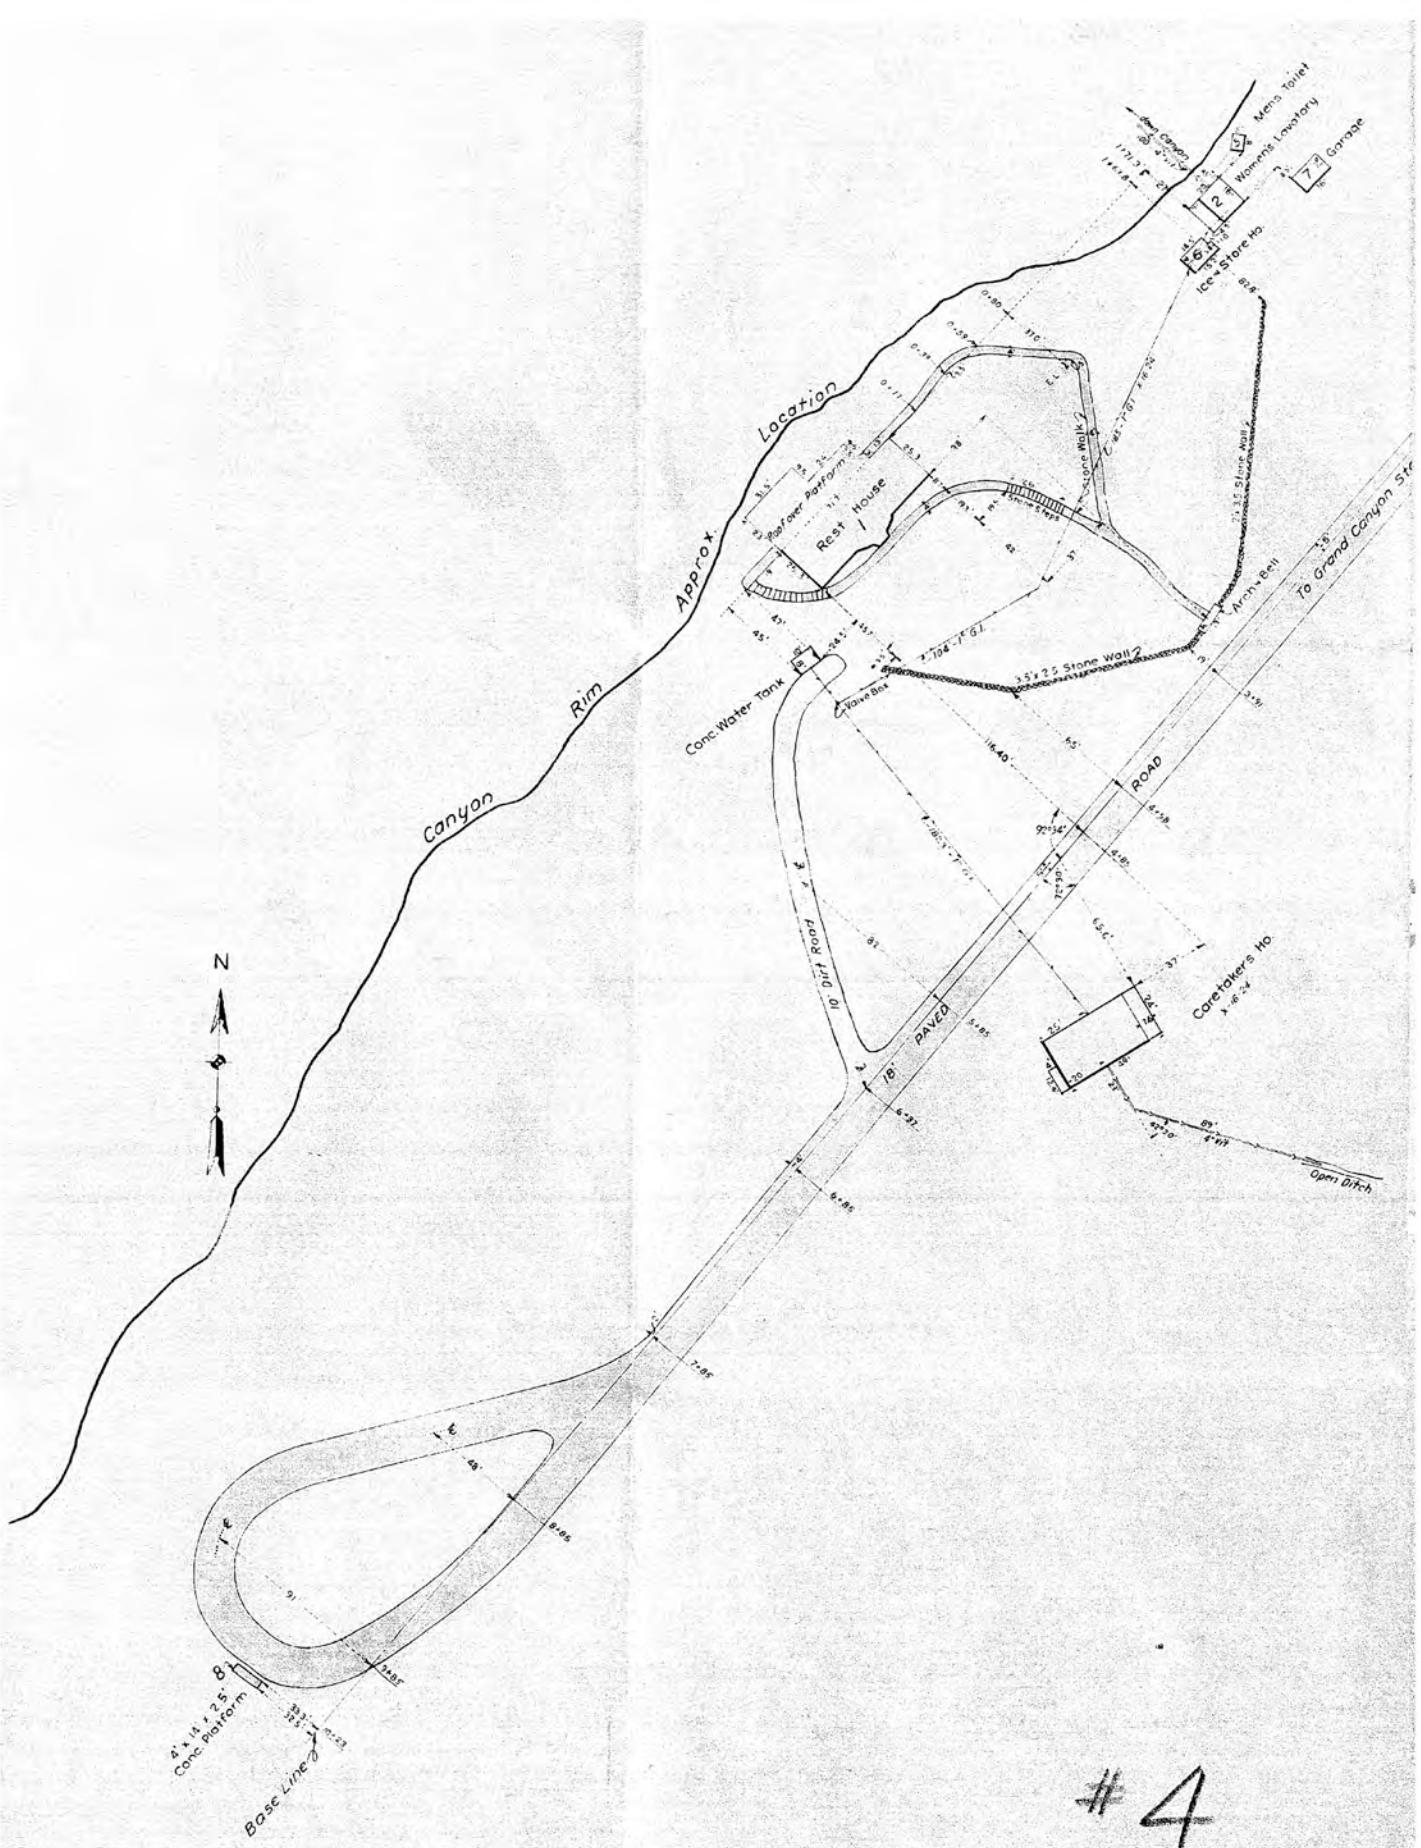




HERMIT'S REST
FEB. 1934 1' 50'
REVISED OCT. 1934

REFERENCE:-
Dwg. C.E.C.L. No. 76-14816
Notes-Auth. X-16-24
T.C.C. Structural Notes Page 49
Location notes of 10-34(D Redline)

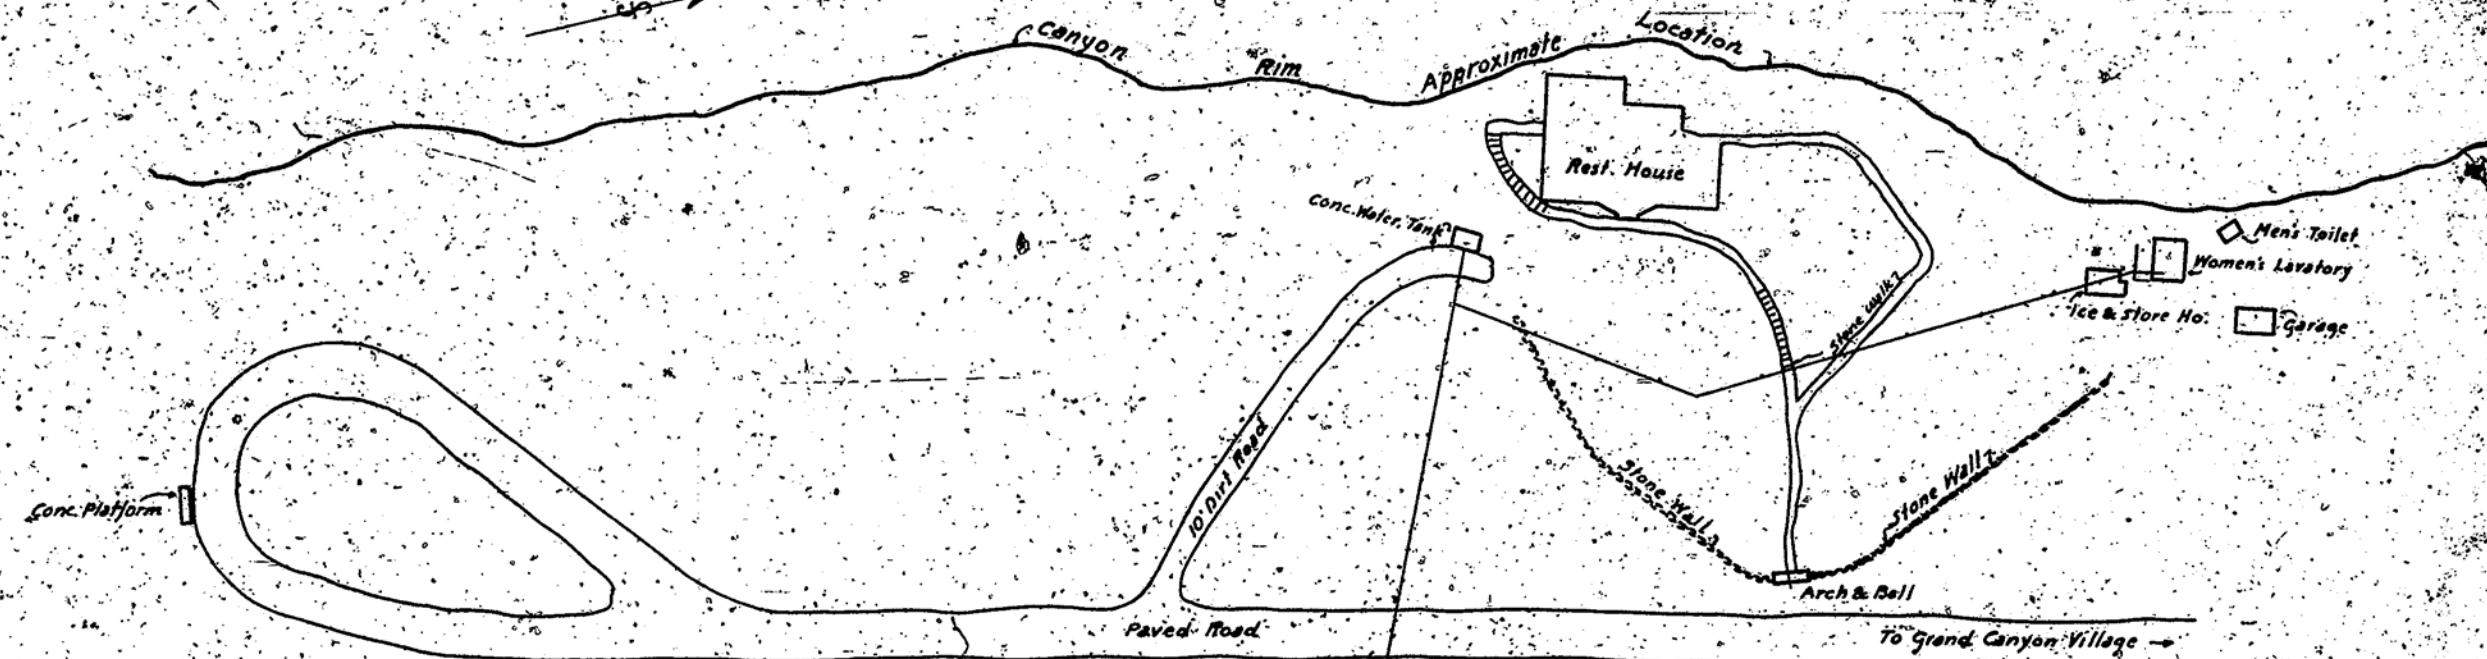


LOCATION PLAN

Scale: 1" = 50ft.

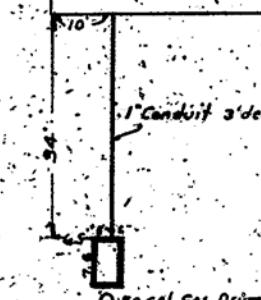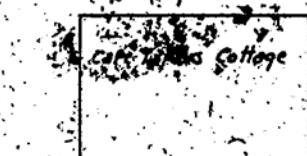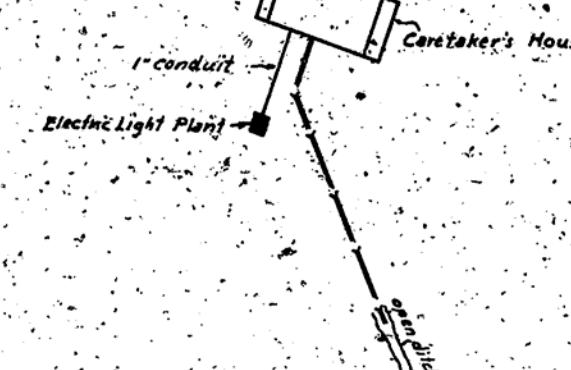

Gasol. Gas Burner

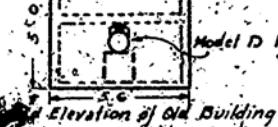

Model D Kohler Plant, 1500 Watt.

Elevation of Old Building used to house Kohler Plant.

DETAIL PLAN

Scale 1" = 50ft.

REDUCED SIZE REPRODUCTION

RECOMMENDED FOR FRED HARVEY
McBeechard THE A.T. & S.P. R.R. CO. DATE 4-20-39

RECOMMENDED FOR CHIEF ARCHITECT
John S. Cross CHIEF ENGINEER DATE 5/19/39


RECOMMENDED FOR SANITARY ENGINEER
CONCURRED FIRE CONTROL EXPERT
CONCURRED FOR SUPERINTENDENT
H.C. Bryant H.C. Bryant DATE 5/11/39

CONCURRED DIRECTOR
APPROVED John S. Cross John S. Cross DATE 5-23-39


ELECTRIC LIGHT PLANT FOR CARE-TAKER'S HOUSE AT HERMIT'S REST
GRAND CANYON, ARIZONA
IN THE
GRAND CANYON NATIONAL PARK
TO BE OCCUPIED AND USED BY FRED HARVEY UNDER 50 YEAR CONTRACT WITH THE SECRETARY OF THE INTERIOR DATED JANUARY 1, 1933
SCALED AS NOTED MARCH 5, 1933
C.E.C.L. NO. 89-21814

NP-GC-9021

GC 9021

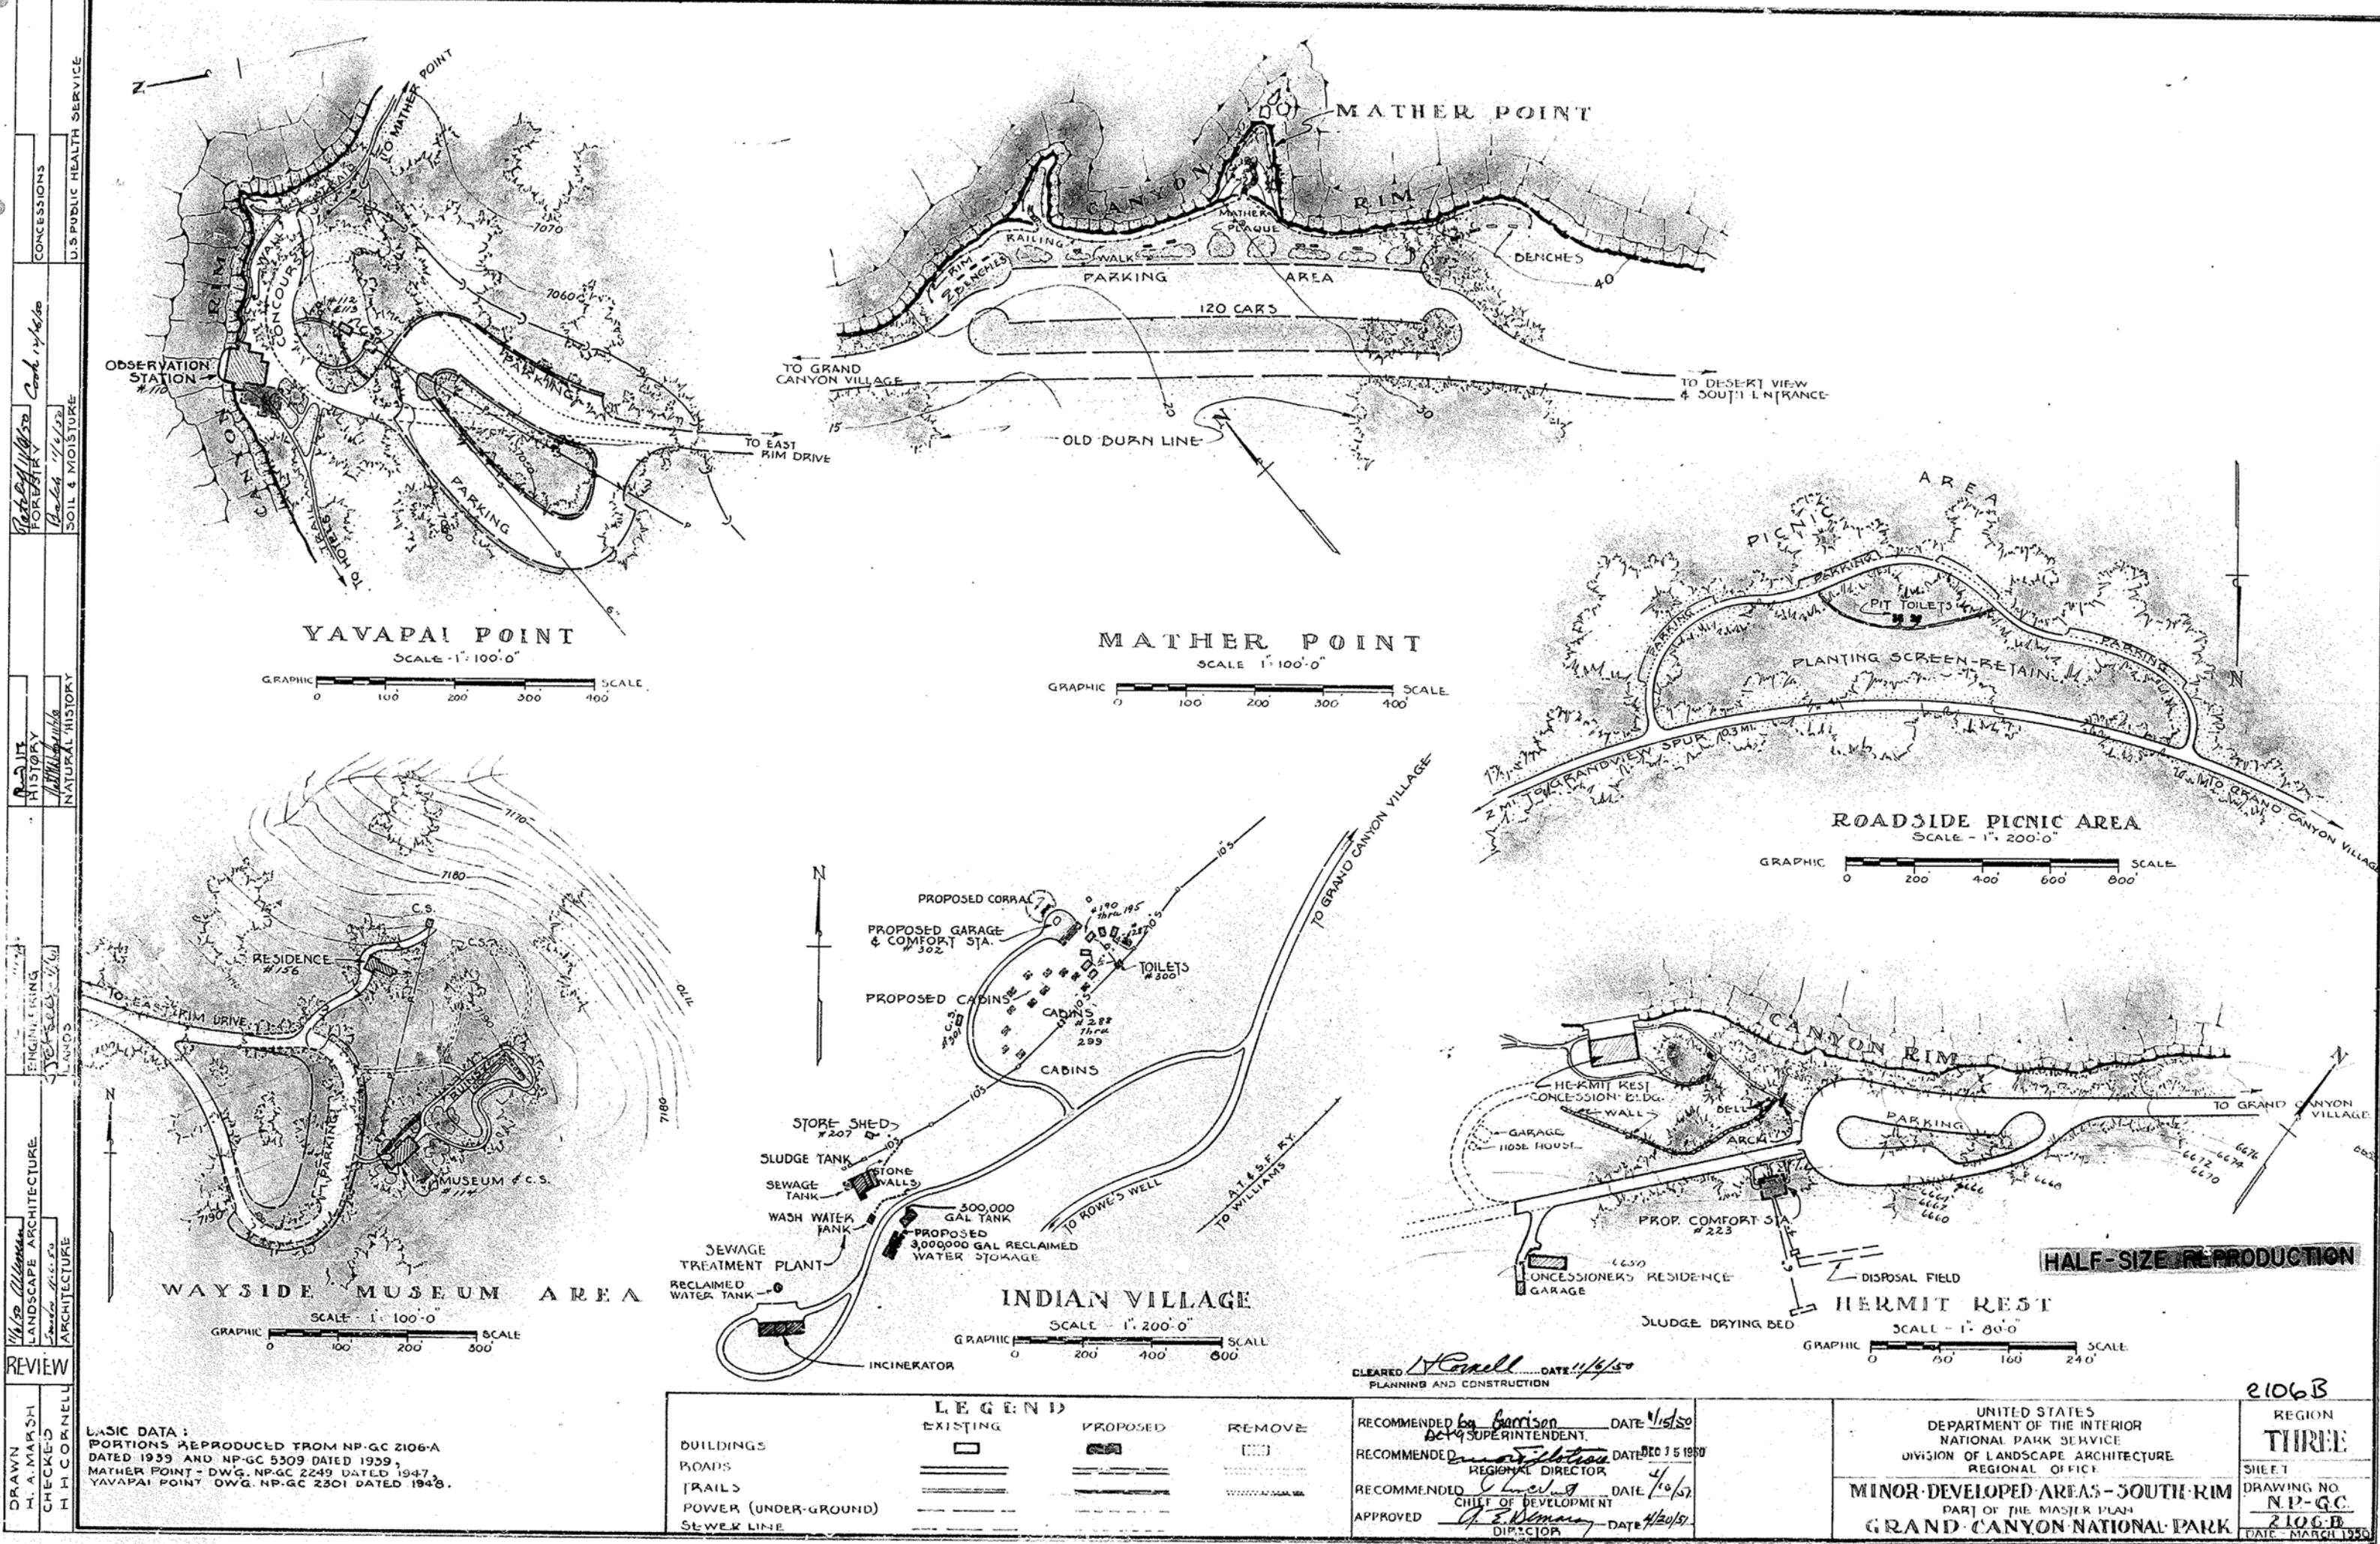

backfill 2' above
top of footing

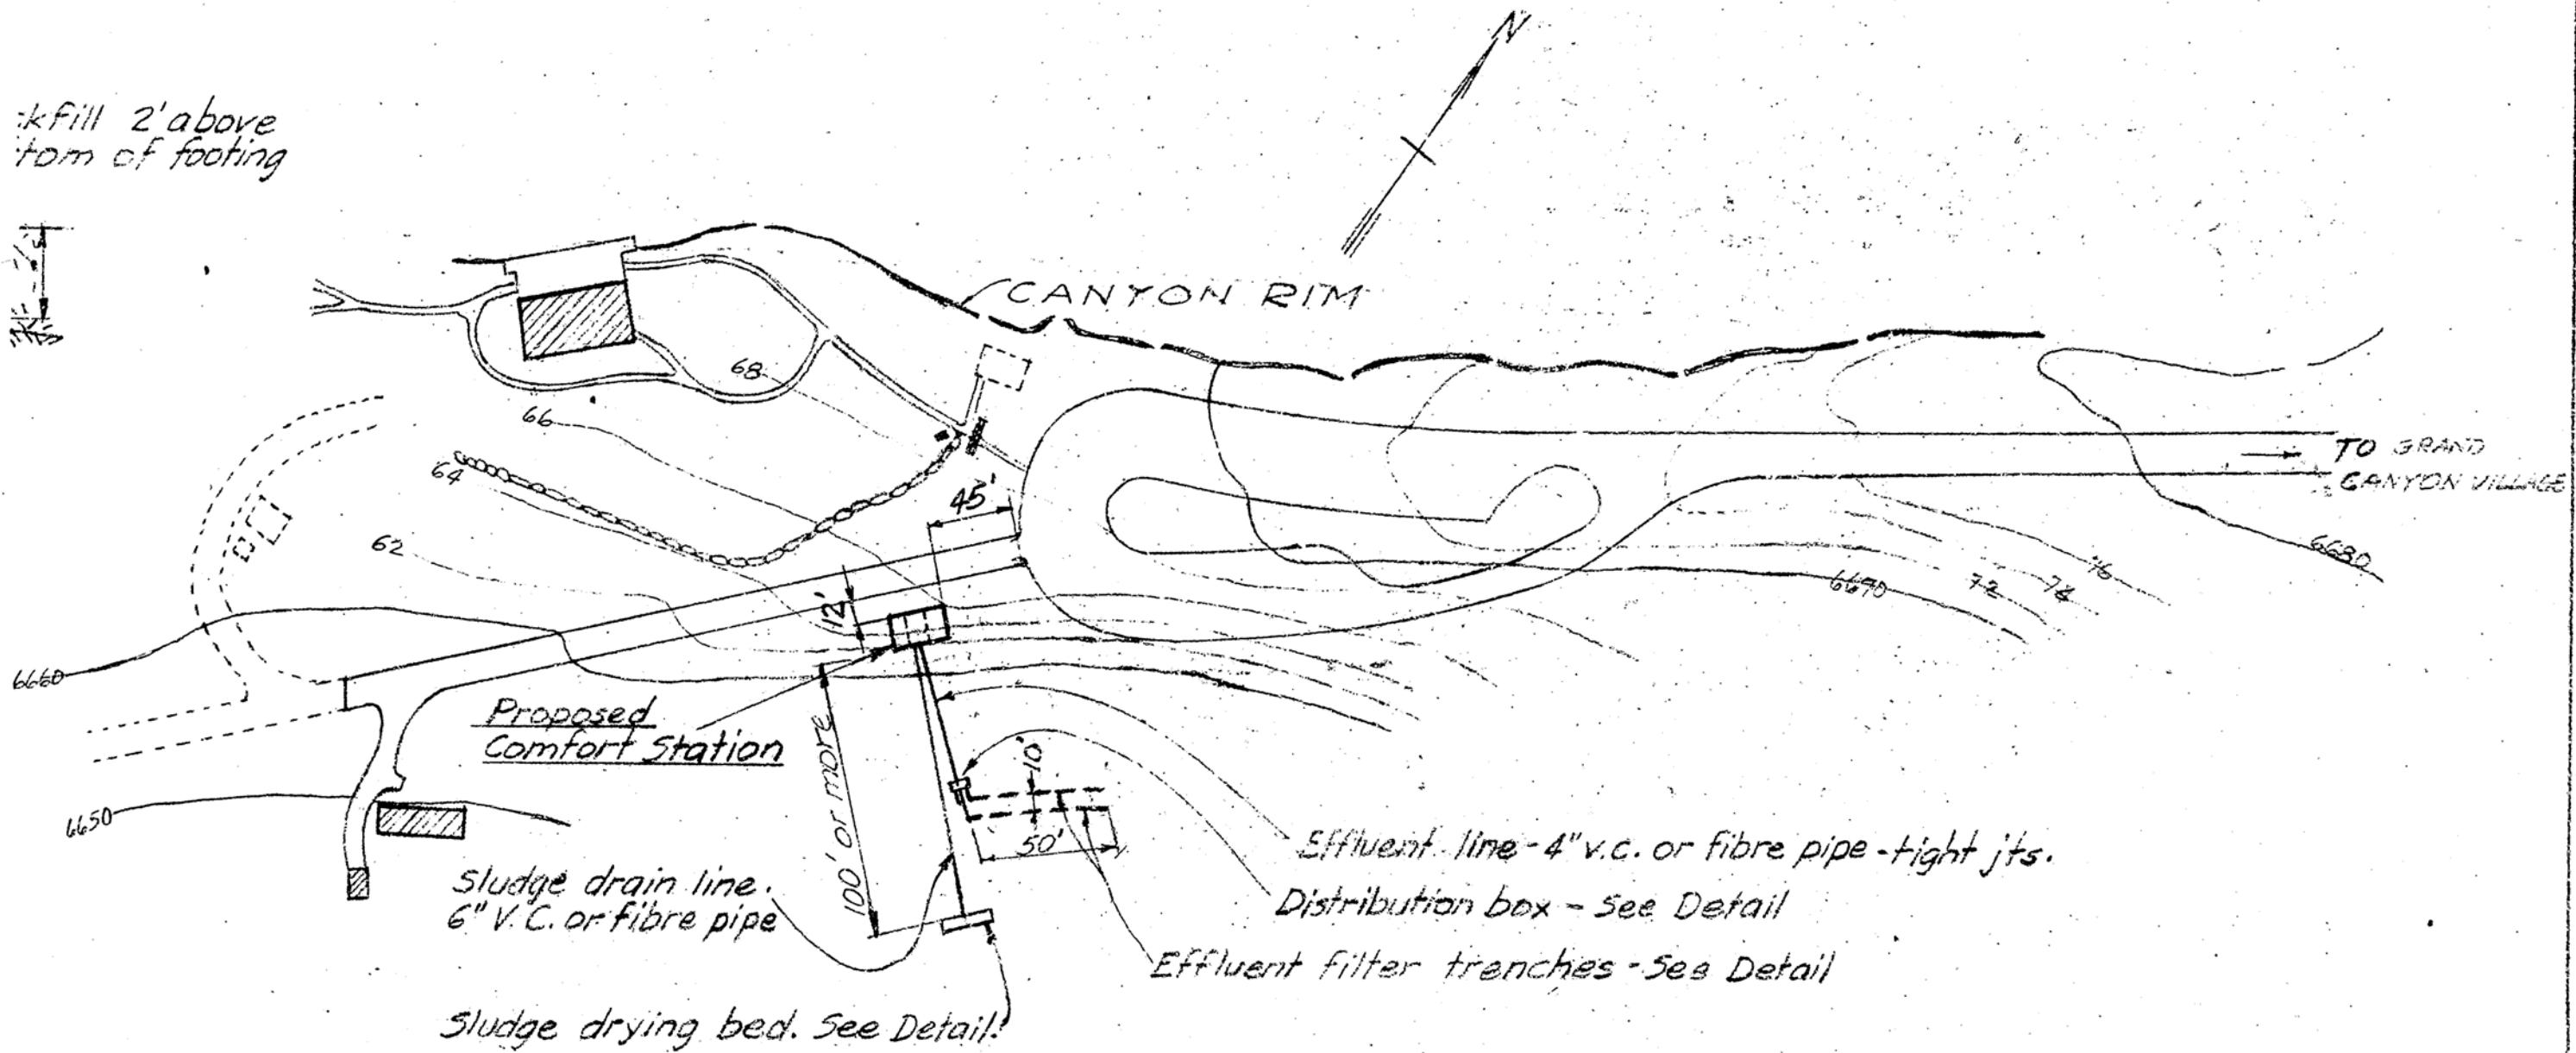

LAYOUT PLAN SEWAGE DISPOSAL & BUILDING LOCATION
SCALE 1" = 50'

5-10-5

Dark File

HERMITS REST

113/60541 101

ORIENTATION
REVIEWEDOPERATIONS
REGION

WASHINGTON

INTERP.
REGION

WASHINGTON

COOP. ACTV.
REGION

WASHINGTON

DES. & CONST.
STAFF

E.

LA. WASHINGTON

E.

LA. OTHER

PREPARED

VIAOUS

DEBRIED

TURFLL'S

DRAWING

M.W.W.

CHECKED

REVISED

DATE (INITIAL)

